

EXHIBIT # 13.01

From: Heller, Christa H (DFW)
To: Andrea Flower
Subject: RE: Notice of Application SEPA Determination and Public Hearing
Date: Thursday, January 28, 2016 2:48:16 PM

Hi Ande,

Thanks for the notice. This is a significant amount of new overwater cover. I would expect to hear some comments from the Muckleshoot Tribe due to its overall size and potential impacts to tribal fishing. Have you heard any comments to date?

Since this pier is so large, I would hope to see a planting plan with more tree species that have the ability to reach over 40-feet in height. WDFW considers vine maple to be a shrub, not a tree as indicated on the proposed planting plan. I would recommend adding two or three additional tree species, such as: big leaf maple, western red cedar, Doug fir, pacific dogwood, Sitka spruce, etc.

Please feel free to pass these comments on to the applicant/agent.

Best,

Christa Heller

Habitat Biologist
Washington Department of Fish and Wildlife
Region 4 – Issaquah Field Office
☎ (425) 313-5681 (office)
✉ christa.heller@dfw.wa.gov



From: Andrea Flower [mailto:aflower@ci.lake-forest-park.wa.us]
Sent: Tuesday, January 26, 2016 4:08 PM
To: Andrew Bauer; Brier; City of Lynnwood; City of Mountlake Terrace; City of Seattle; City of Shoreline; David Matulich; Diane Pottinger (DianeP@northcitywater.org); DNR RE SEPACENTER; ECY RE SEPA REGISTER; Doug Mitchell; Jeff LaFlam; Karen Walter; Kim Angel; King County Metro Transit; King County Wastewater Treatment Division; King County Water District 83; Mamie Bolender (info@lfpsf.org); Margaret Duncan; Margaret Salmi; Mark Gregg (mgregg@ronaldwastewater.org); Marla Miller; Northshore Utility; PSRC contact (lmiller@psrc.org); Shoreline Wastewater Management; Heller, Christa H (DFW)
Cc: Jake Tracy
Subject: Notice of Application SEPA Determination and Public Hearing

Dear SEPA Administrators,

Attached, you'll find signed our LFP SEPA DNS document and the associated SEPA Checklist, as well

EXHIBIT # 13.02



King County

Department of Natural Resources and Parks
Wastewater Treatment Division

King Street Center, KSC-NR-0505
201 South Jackson Street
Seattle, WA 98104-3855

February 9, 2016

Sent via email: aflower@cityofflp.com

Ande Flower, Assistant Planner
17425 Ballinger Way NE
Lake Forest Park, WA 98155-5556

Dear Ms. Flower:

The King County Wastewater Treatment Division (WTD) has reviewed the Notice of Application and SEPA Environmental Checklist for a proposed pier at 17350 Beach Drive (File Numbers 2015-SSD-0001 & 2015-SSD-0010). A WTD facility, the Kenmore Interceptor Section 2 lake line, is in the vicinity of the proposed pier. We have enclosed record drawings of this facility.

In order to protect this wastewater facility, **WTD requests that the City of Lake Forest Park submit final construction drawings for the project, showing the location of the Kenmore Interceptor lake line**, so that WTD can assess the proposed project's impacts. Please send drawings to:

Mark Lampard, Local Public Agency Coordinator
King County WTD, Project Management Unit
201 South Jackson Street, KSC-NR-0508
Seattle, WA 98104-3855
(206) 477-5414
mark.lampard@kingcounty.gov

In addition, please contact Mr. Lampard a minimum of 72 hours prior to commencing any construction in order to allow staff time to arrange for a King County Inspector to be on the site during construction.

Thank you for the opportunity to review and comment on this proposal.

Sincerely,

Jacob Sheppard
Water Quality Planner



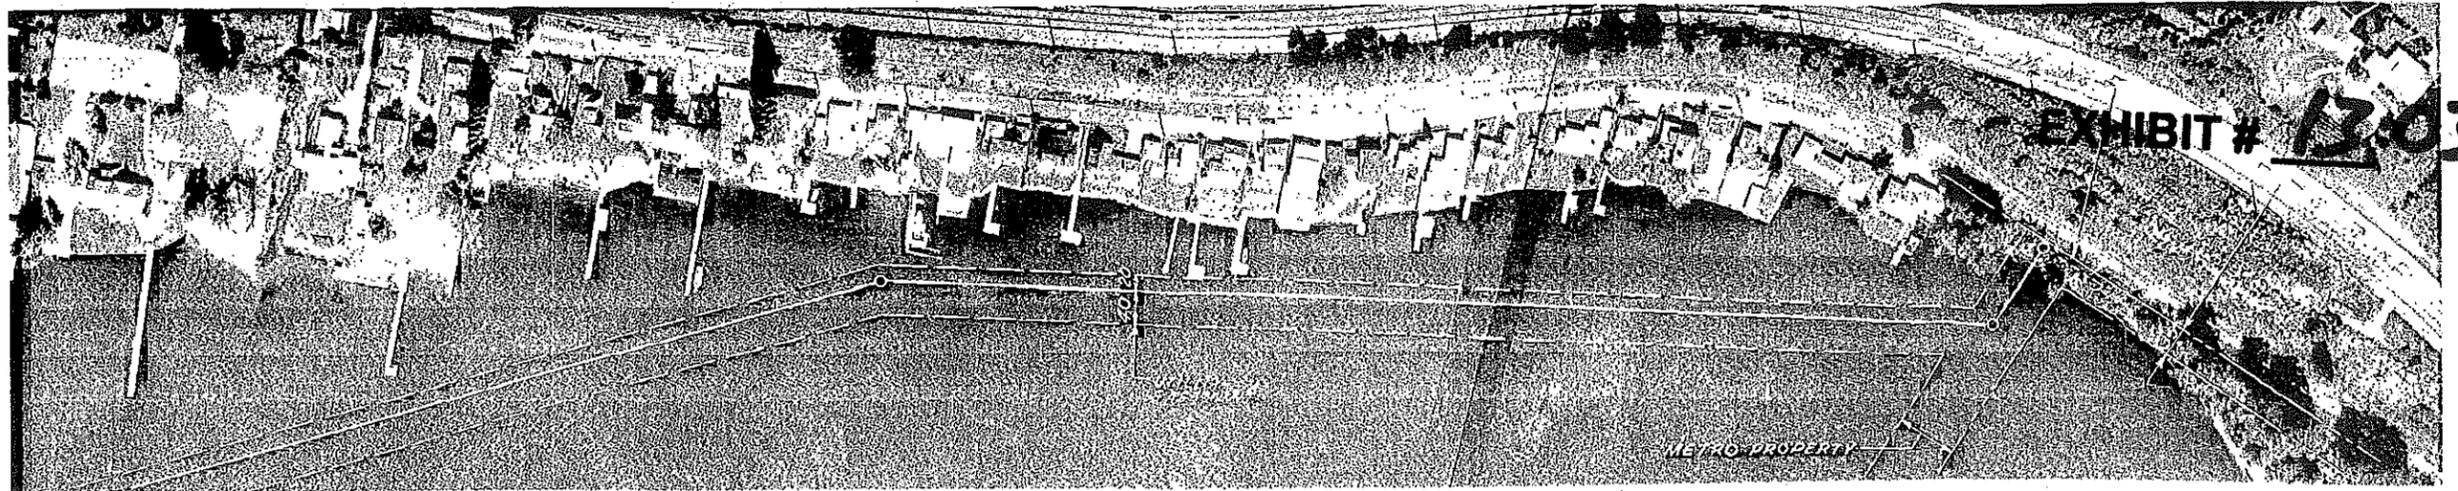


EXHIBIT # 13.03

AERIAL PHOTOGRAPHS PERFORMED MAY 1960 DO NOT REFLECT CHANGES SINCE DATE OF PHOTOGRAPHY.

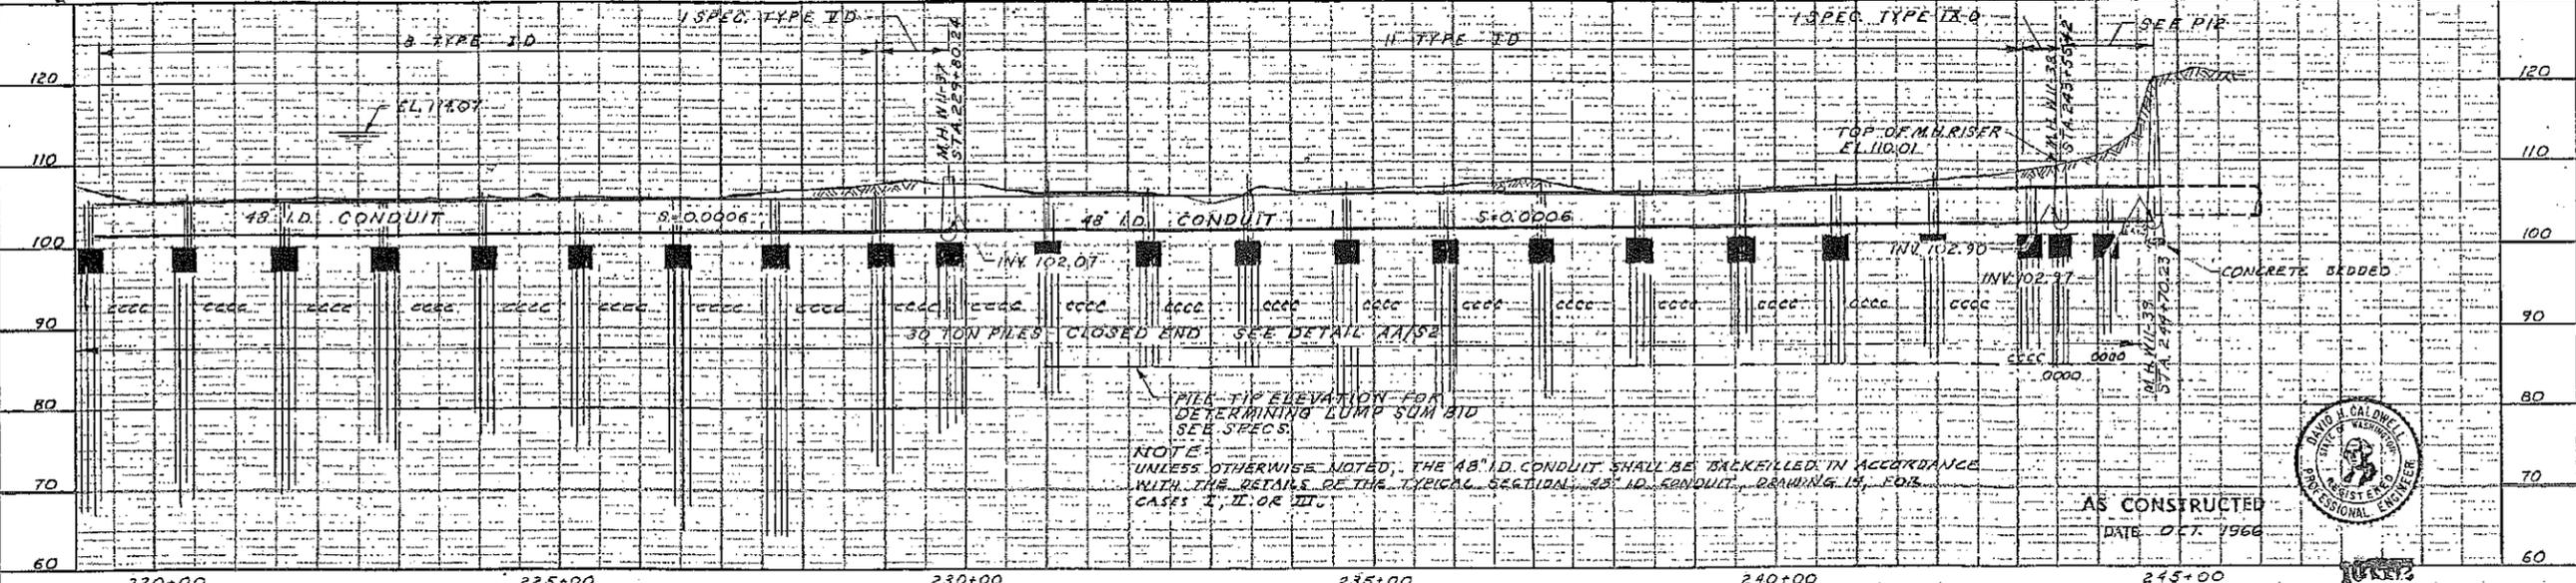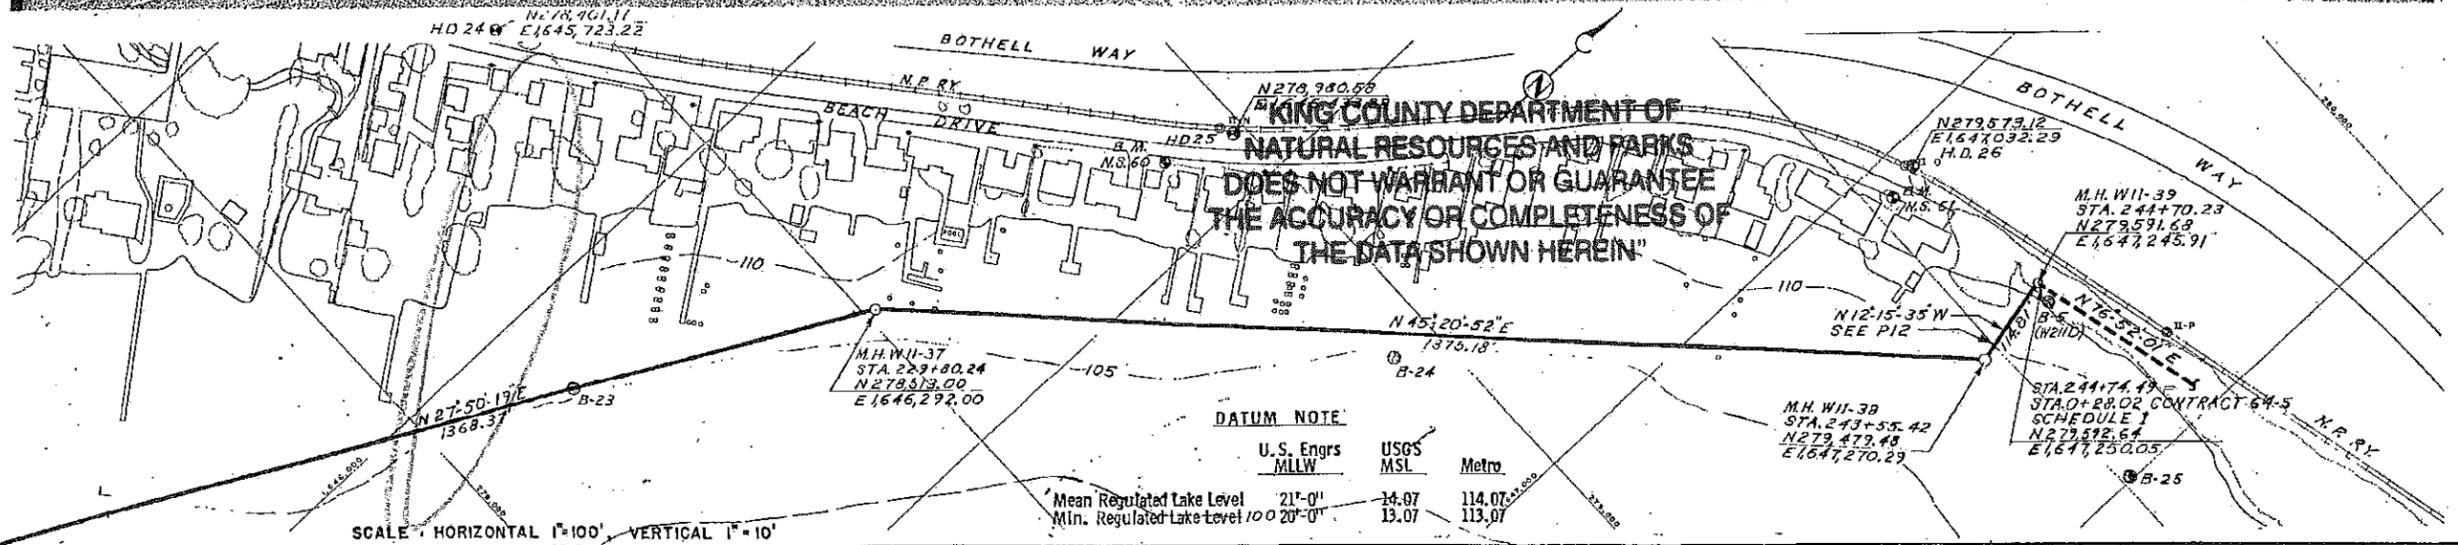

DESIGNED BY: JFL	METROPOLITAN ENGINEERS	MUNICIPALITY OF METROPOLITAN SEATTLE	FILE: W211C	WEST POINT SYSTEM	KENMORE INTERCEPTOR SECTION 2 STA. 219+50 TO STA. 244+70.23 (END)	DRAWING NUMBER P9
DRAWN: DLO	BROWN AND CALDWELL HILL AND IRIGMAN	APPROVED: <i>[Signature]</i>	SCALE: AS NOTED	DATE: AUG. 1964		SHEET NUMBER 22 OF 27
CHECKED: JFL	CAREY AND KRAMER R.W. BECK AND ASSOCIATES	RECOMMENDED BY: <i>[Signature]</i>				